
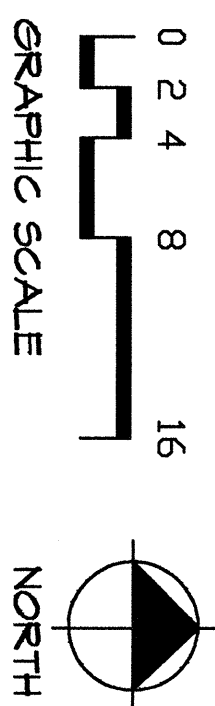


Exhibit A: Floor Plan

FLOOR PLAN

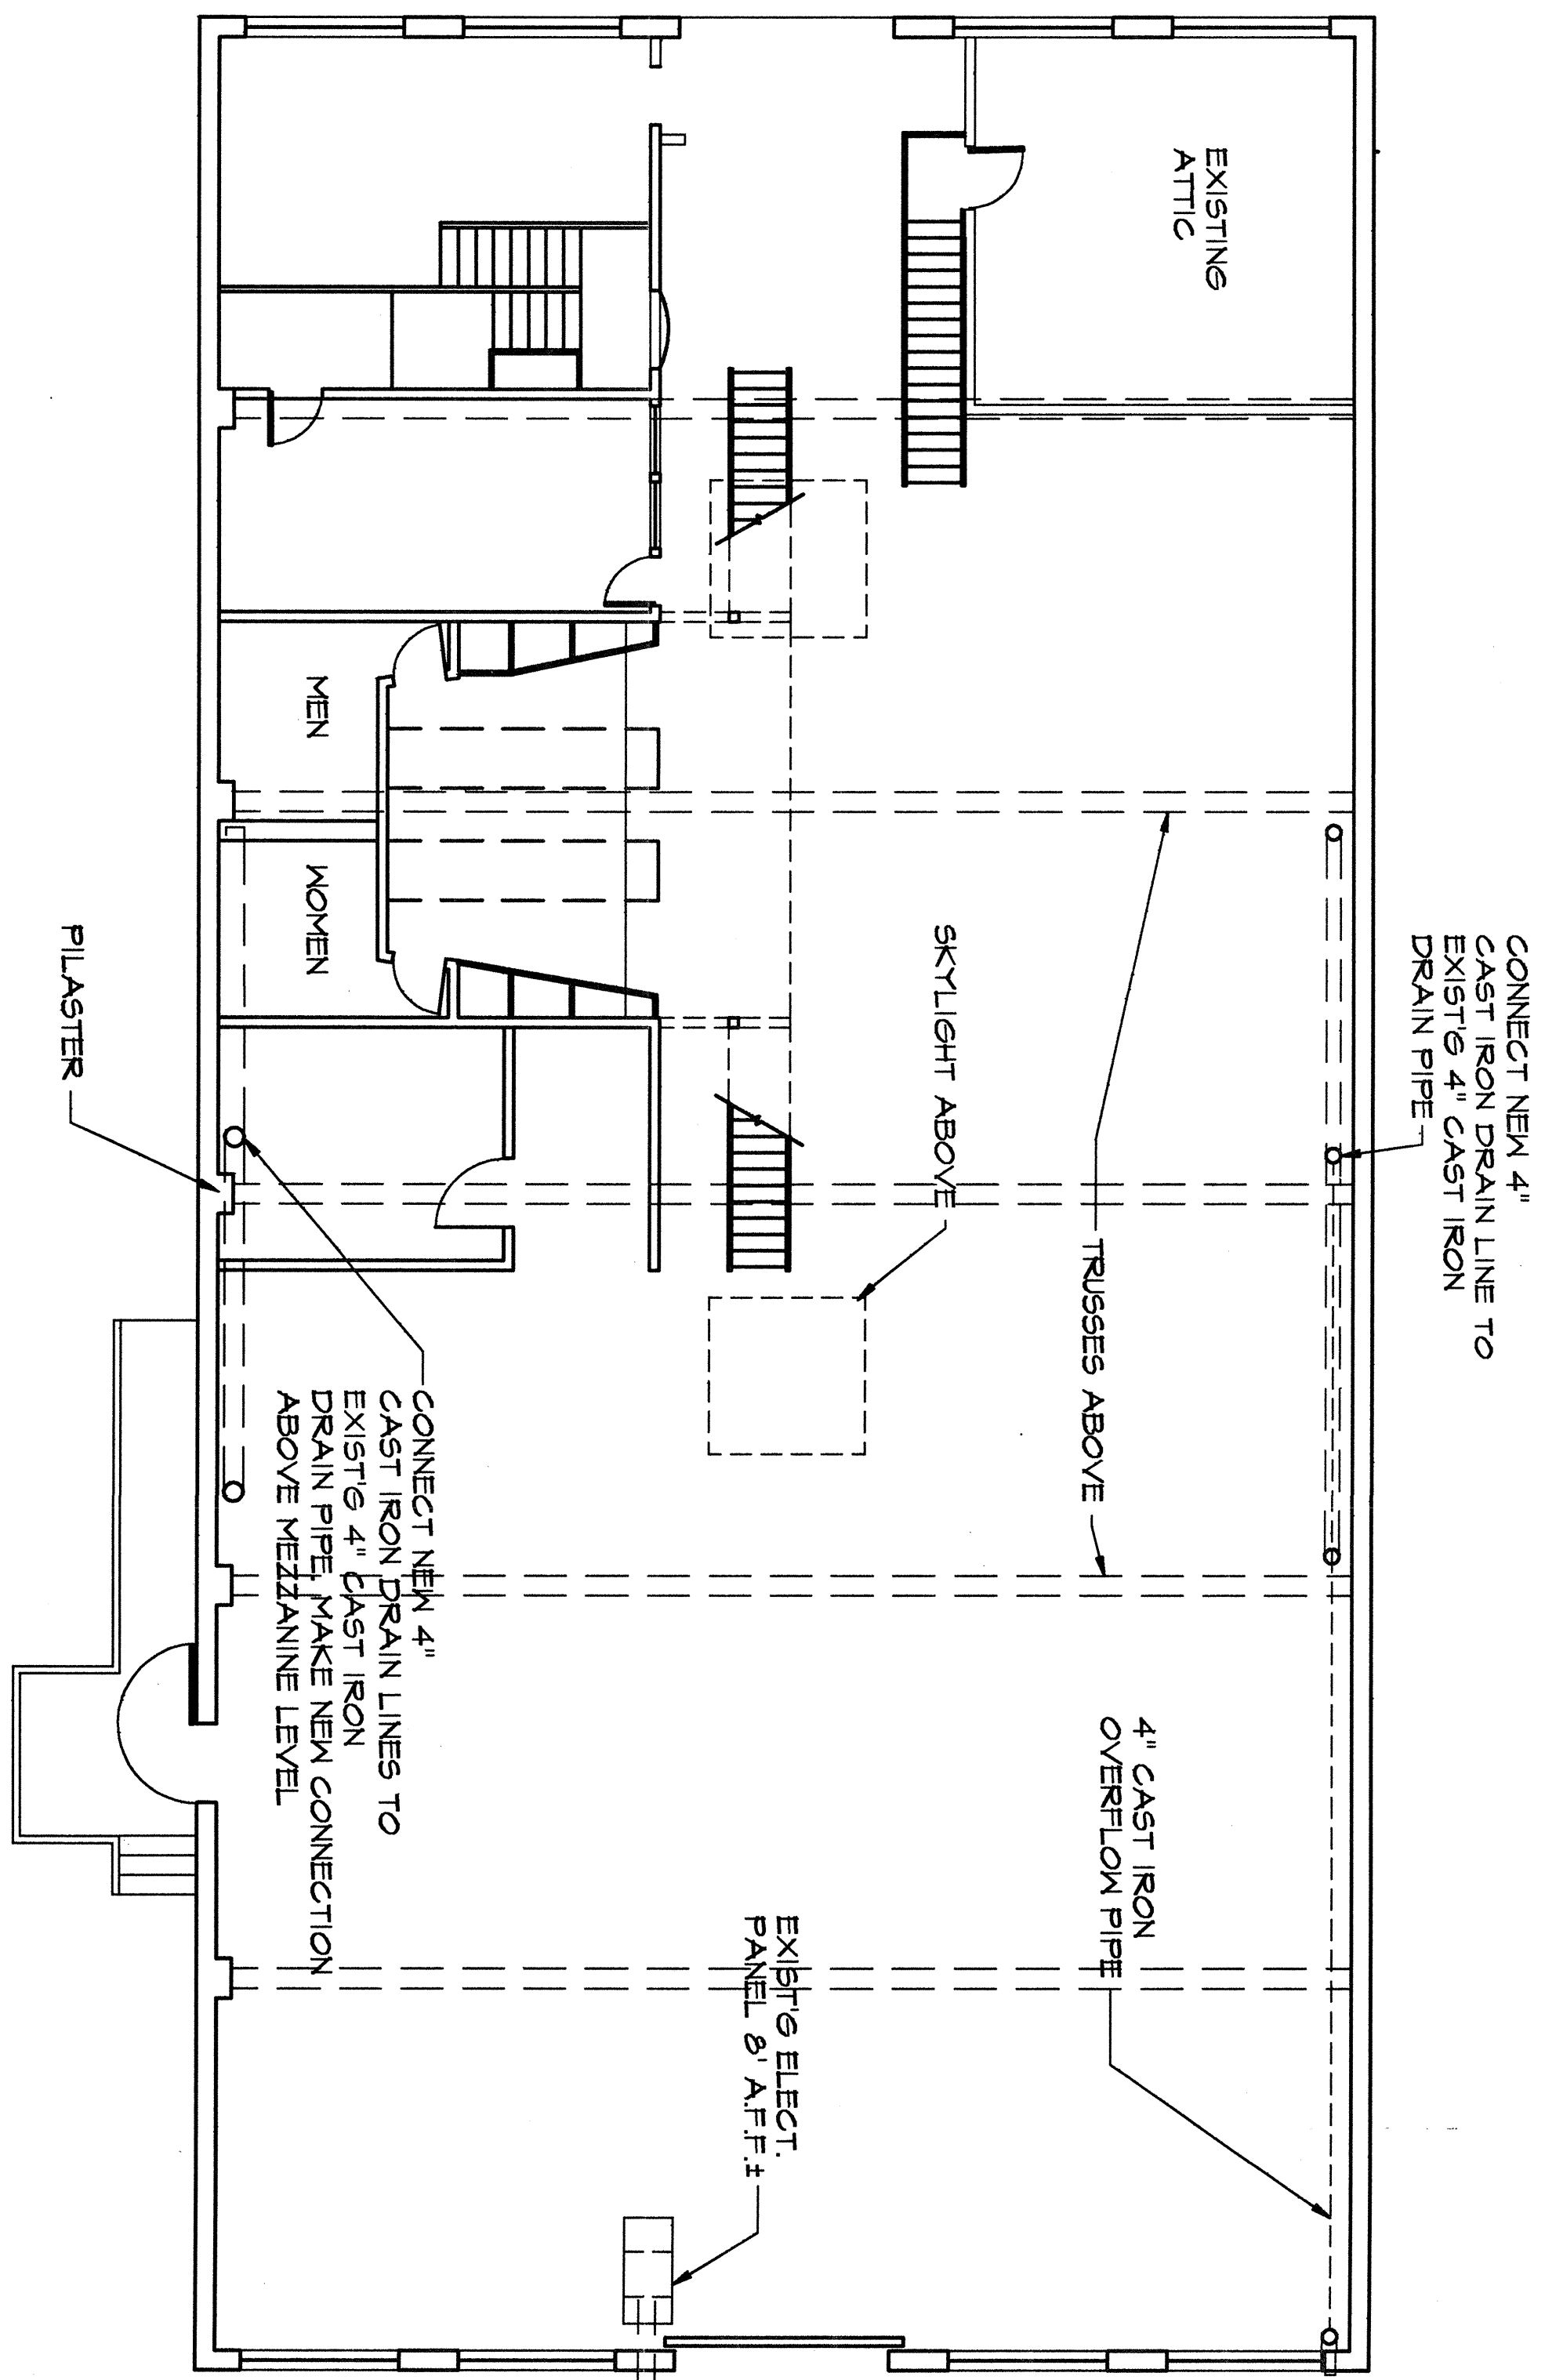

19.016	Barbara MW
A-14	General Facility
	Seattle Center
	Reroofing
	FLOOR PLAN

30.113

AS-BUILT DRAWINGS

SHEET **A-14**

SCALE	DRAWN BY	CHECKED BY	ORIG. ISSUE	REV. ISSUE
AS NOTED	BB	MMB	11 MAR 1993	

Van Horne architects
VAN HORNE

REGISTERED ARCHITECT
Barbara M. W.
CORPORATE & COMMERCIAL ARCHITECTS
STATE OF WASHINGTON

SEATTLE CENTER
SEATTLE CENTER
REROOFING
POTTERY NORTHWEST BUILDING
FLOOR PLAN

APPROVED FOR ADVERTISING
KENNETH J. NAKATSU
DIRECTOR OF ADMINISTRATIVE SERVICES
SEATTLE, WASHINGTON

BY: *Barbara M. W.* **March 9, 1993**
CONTRACTING SERVICES ADMINISTRATOR
SEA. CTR. DIR. OF REDVPT.

NO.	REVISION	DATE	NO.	REVISION	DATE