


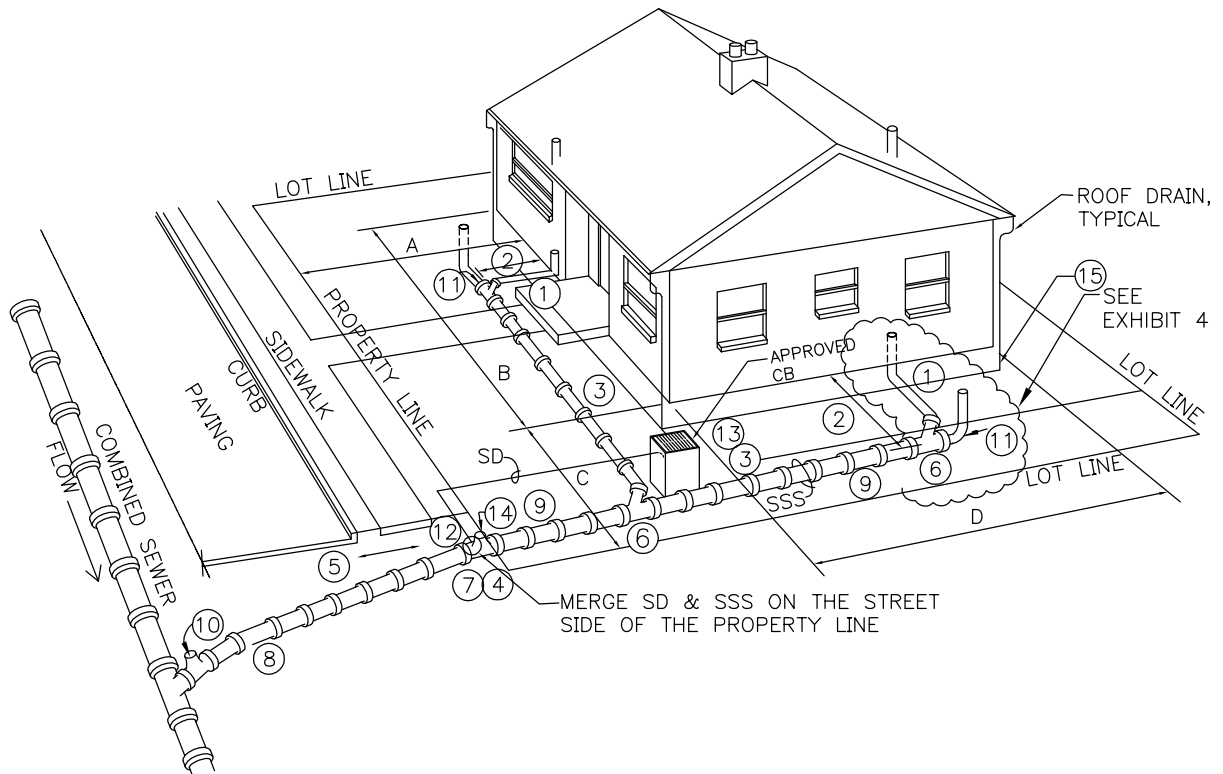

NOTES:

1. ALL HOUSE PLUMBING OUTLETS MUST BE CONNECTED TO THE SEWER. DOWNSPOUTS AND DRAINAGE WATER SHALL BE CONNECTED TO A SEPARATE STORM DRAINAGE SYSTEM, IF AVAILABLE.
2. 2'-6" MIN DISTANCE FROM HOUSE, EXCEPT FOR SOIL PIPE CONNECTION.
3. 1'-6" MIN COVER OF PIPE.
4. 2'-6" MIN COVER AT PROPERTY LINE.
5. 5'-0" MIN COVER AT CURB LINE.
6. LAY PIPE IN STRAIGHT LINE BETWEEN BENDS. MAKE ALL CHANGES IN GRADE OR LINE WITH BENDS OR WYES.
7. STANDARD 4" TO 6" INCREASER.
8. 6" SEWER PIPE: MIN SIZE IN STREET, AND ELSEWHERE AS DIRECTED. 2% MIN GRADE, 100% MAX.
9. 4" SEWER PIPE: MIN SIZE ON PROPERTY. 2% MIN GRADE, 100% (45°) MAX.
10. TEST "T" WITH PLUG.
11. CLEANOUT.
12. CONNECTION TO SIDE SEWER REQUIRES SIDE SEWER TO BE 6".
13. TYPE 50 CATCH BASIN OR P-TRAP AT EACH DOWNSPOUT.
14. TEST "T" WITH PLUG AT UPSTREAM SIDE OF SIDE SEWER AS REQUIRED.
15. P-TRAP AT ALL DOWNSPOUTS IF CB IS NOT USED.
16. ALL CONSTRUCTION REQUIRES A PERMIT AND PAYMENT OF FEE. COMPLETE LEGAL DESCRIPTIONS OF PROPERTY AND DIMENSIONS A, B, C AND D THAT SHOW THE SIZE AND LOCATION OF THE HOUSE ARE REQUIRED FOR ISSUANCE OF THE PERMIT.
17. CONSTRUCTION IN STREET MUST BE DONE BY A REGISTERED SIDE SEWER CONTRACTOR.
18. ALL CONSTRUCTION SHALL BE IN ACCORDANCE WITH CURRENT SIDE SEWER ORDINANCES.
19. ORDINANCE 97016 APPLIES TO INSTALLATION OF SIDE SEWER.

NTS