REGION NO.	STATE	FEDERAL AID PROJECT NO.	SHEET NO.
10	WA	NCPD-DEMO-STPUL-2001(050)	

CITY OF SEATTLE

SOUTH SPOKANE STREET VIADUCT
EASTBOUND 4th AVENUE SOUTH OFF-RAMP

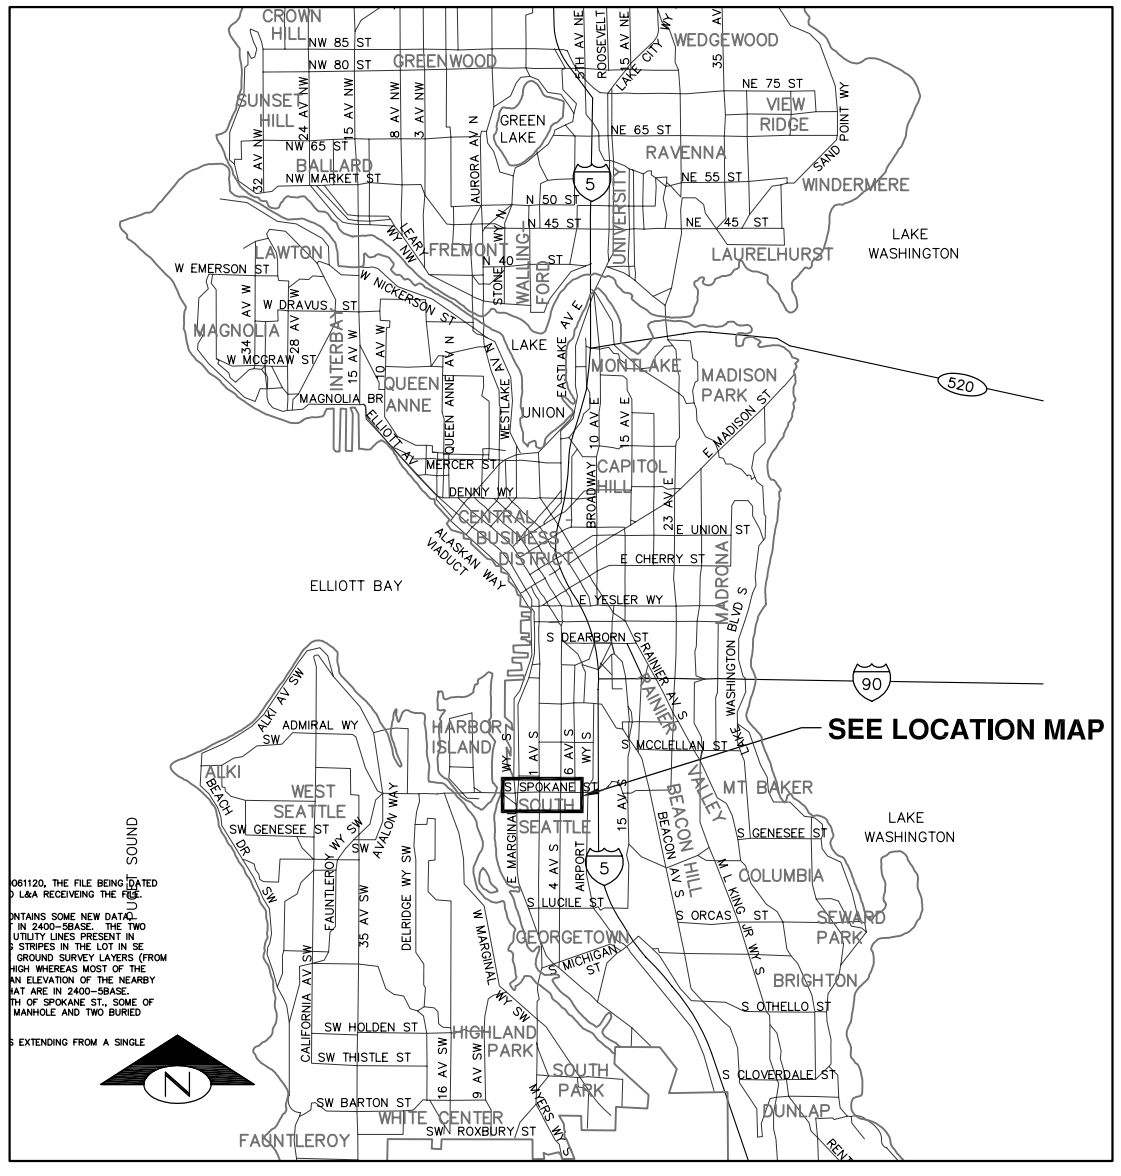

VICINITY MAP

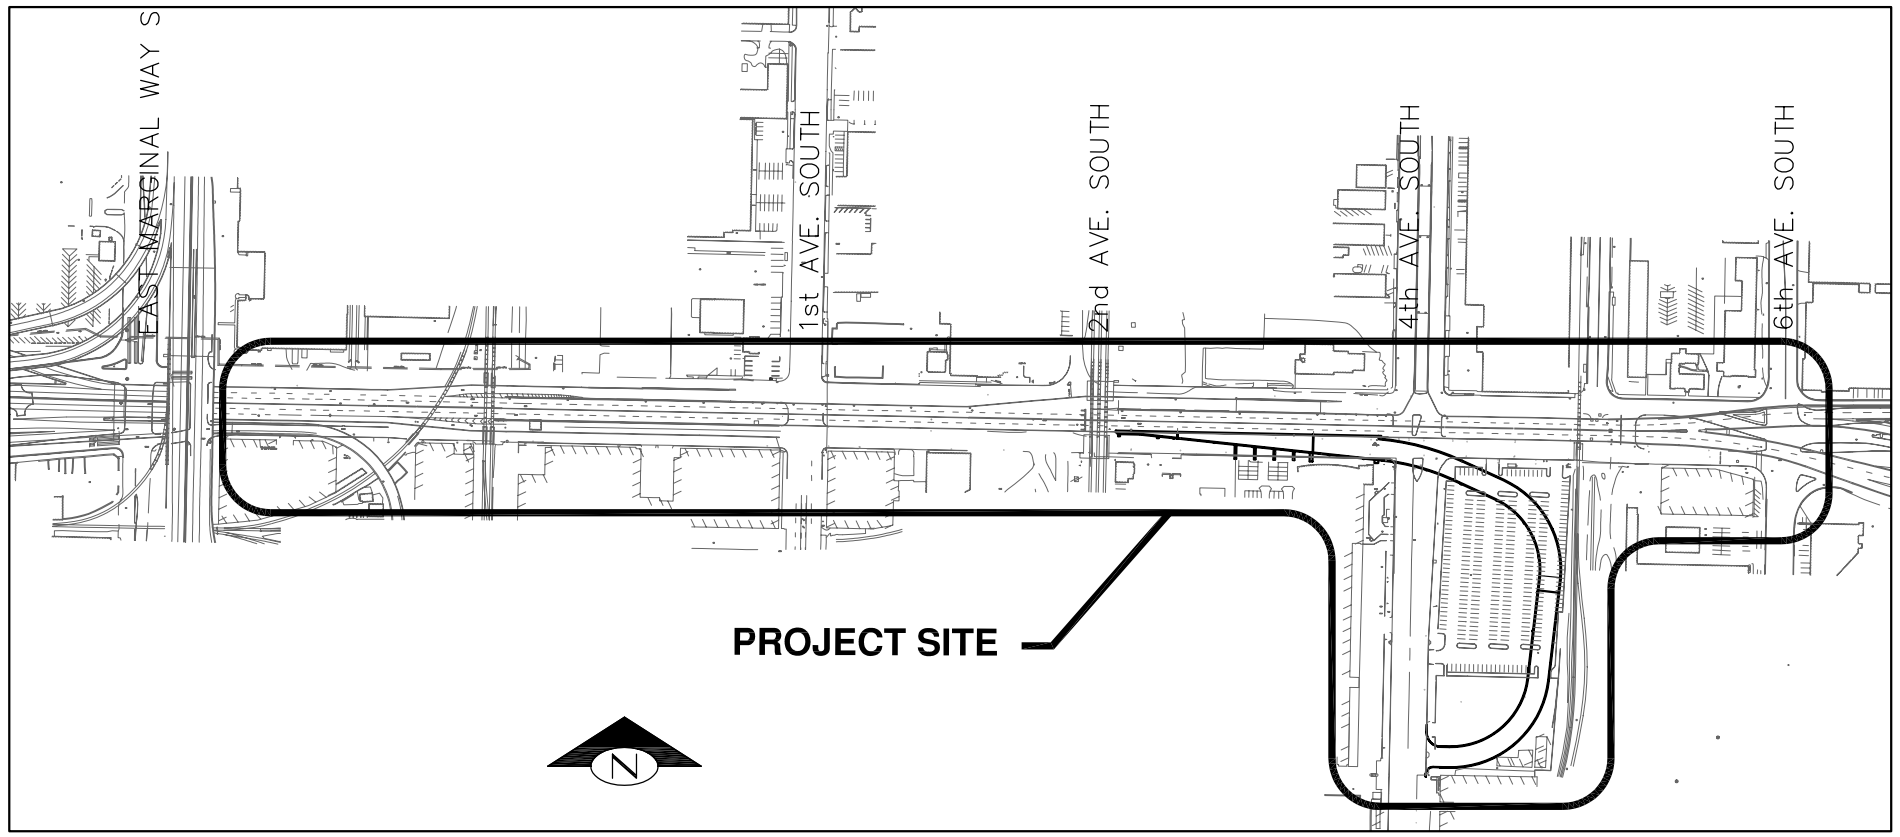

LOCATION MAP

100% SUBMITTAL
NOT FOR CONSTRUCTION
August 26, 2008

COVER SHEET
PROJECT LOCATION AND VICINITY MAPS G1

JE JACOBS
600 108th Avenue N.E.
Bellevue, Washington 98004

APPROVED FOR ADVERTISING
FRED PODESTA
DEPARTMENT OF EXECUTIVE ADMINISTRATION
SEATTLE, WASHINGTON . . . . . 20 . . .
BY: . . . . . .
DIRECTOR, CONTRACTING SERVICES

NAME OR INITIALS AND DATE	
DESIGNED	BSM 12/07
CHECKED	WBH 4/08
DRAWN	BLP 11/07
CHECKED	KTF 2/08

INITIALS AND DATE	
REVIEWED:	
DES.	CONST.
SDOT	PROJ. MGR.
RECEIVED	
REVISED AS BUILT	

ALL WORK DONE IN ACCORDANCE WITH THE CITY OF SEATTLE STANDARD PLANS AND SPECIFICATIONS AND OTHER DOCUMENTS CALLED FOR IN SECTION 0-02.3 OF THE PROJECT MANUAL.

WILLIAM B. HICKEY
STATE OF WASHINGTON
13509
REGISTERED
PROFESSIONAL ENGINEER

City of Seattle
Seattle Department of Transportation
ORDINANCE NO. . . . . APPROVED . . . . . .
FUND: . . . . . .
SCALE: H. V. INSPECTOR'S BOOK . . . . . .

SOUTH SPOKANE STREET VIADUCT
EASTBOUND 4TH AVENUE SOUTH
OFF-RAMP

JOB NO.	
PC	TS4047A
R/W	TS4047B
CO	TS4047C
VAULT PLAN NO.	782-273
SHEET	1 OF 219

NO.	REVISION	BY	DATE	APP'D
	MADE TO CONFORM TO AS-BUILT CONDITIONS	MARK TOKITA	3/07/09	

WHEN PRINTED ON 36" WIDE MYLAR

8/23/2008 10:22 AM

Attachment C to SDOT Spokane Street Viaduct 4th Avenue South Off-Ramp FISC

P:\WX\4704\00\CAD\TS4047A00100#.dwg

Gretchen M. Haydel, SDOT Vicinity Map ATT C, May 03, 2011